


平楽中学校 オフセット図

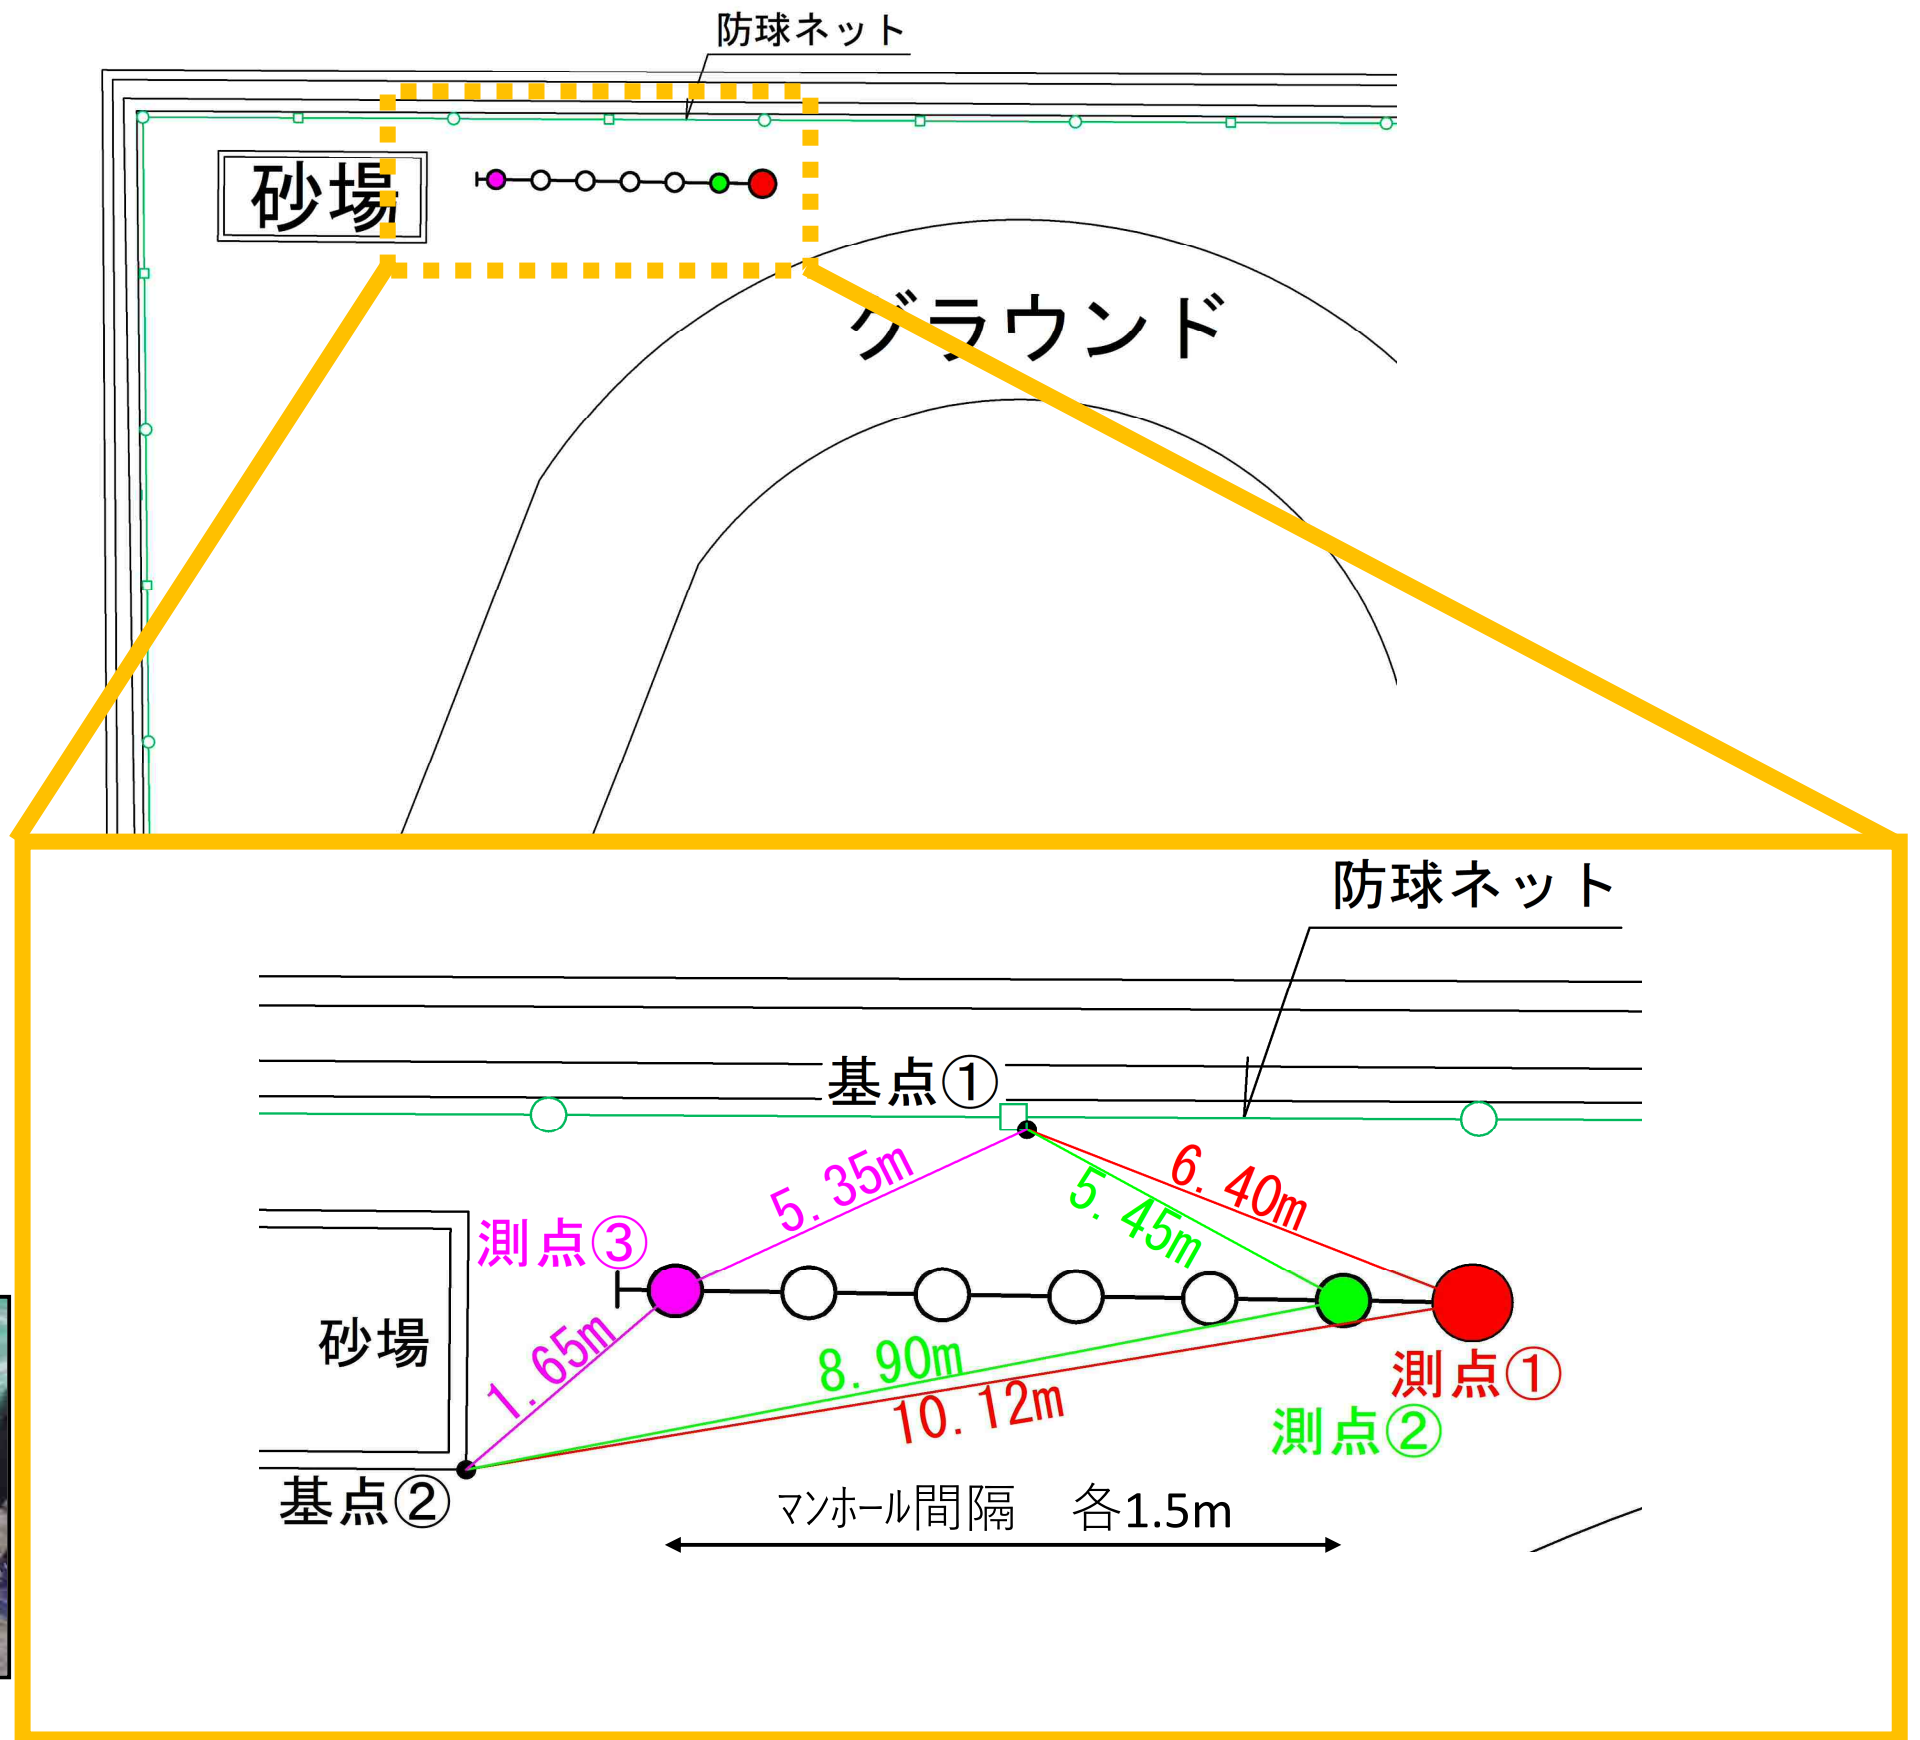

铸铁製防護ふたT-14 300

塩ビ製内ふた200

測点① : 15.5cm
測点② : 12cm
測点③ : 11cm

