


802

活 2

井土ヶ谷地区確定図第2号

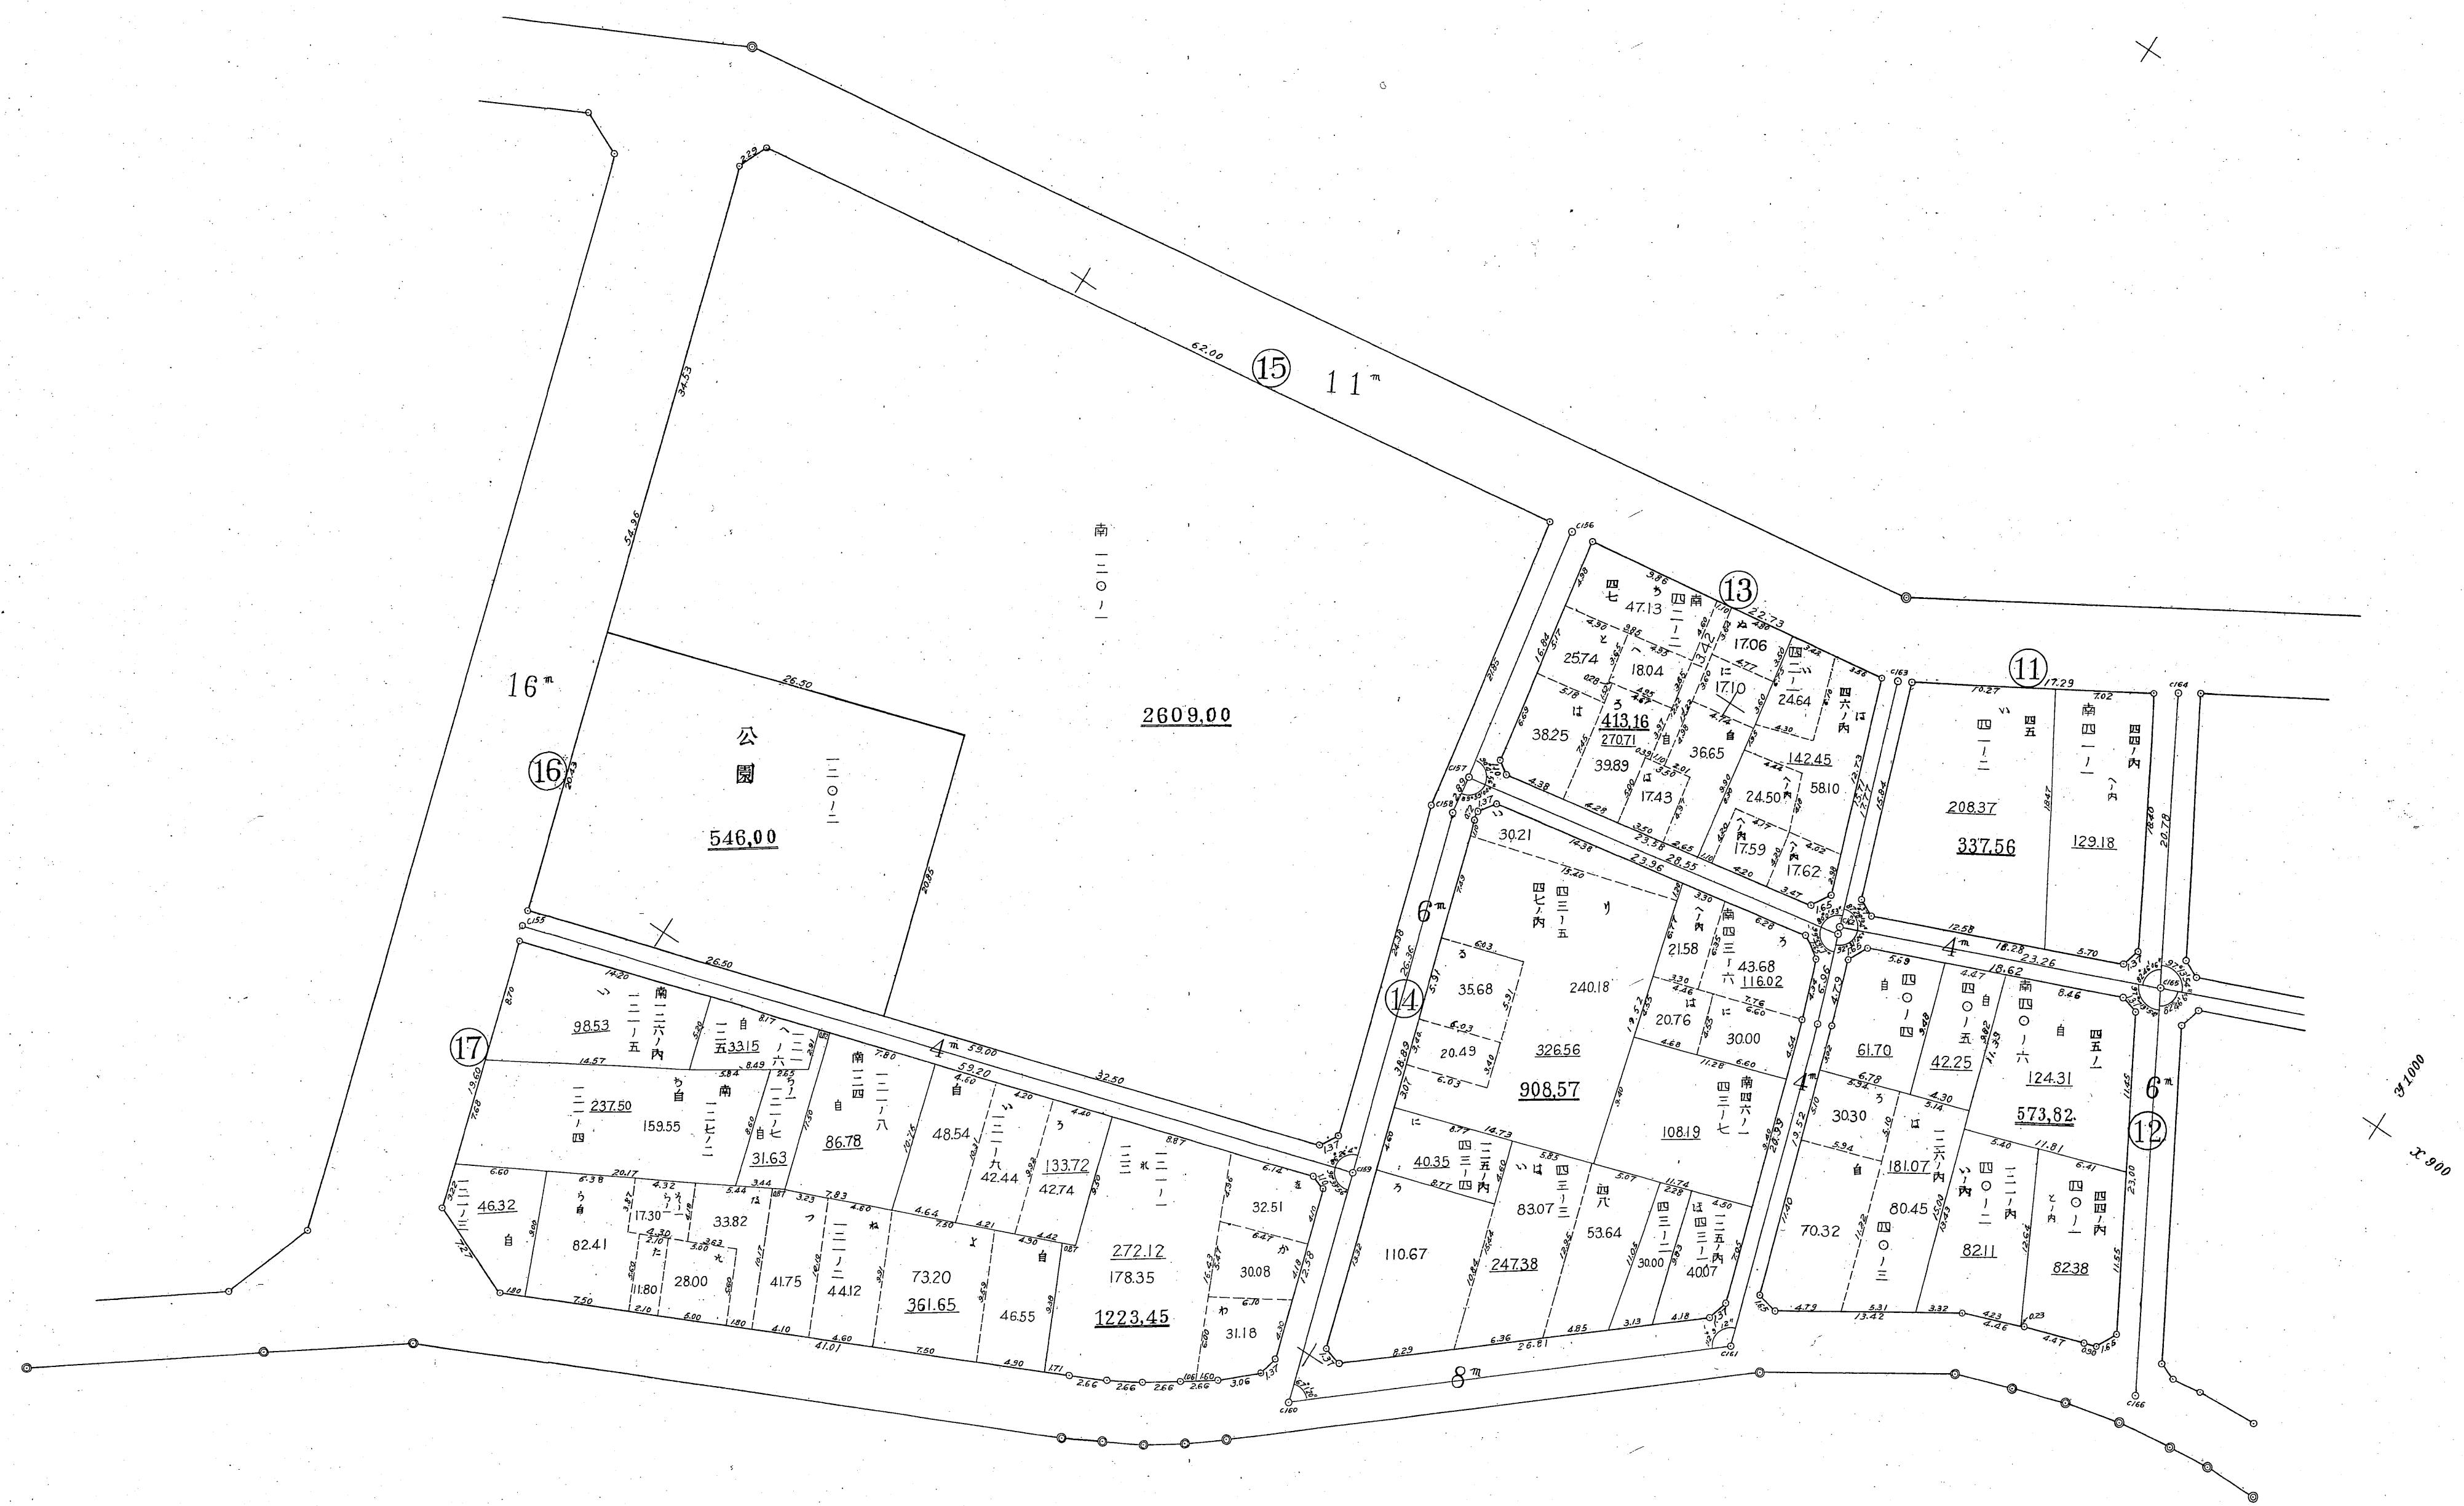

3700



805

井土ヶ谷地区確定図第5号



井土ヶ谷地区確定図第6号

第 6

896



807

井土ヶ谷地区確定図第七号



井土ヶ谷地区確定図第8号

